


FILE: H:\2017\1704221\1704221-AS-BUILT LANDSCAPE-PLANNING
 COMMENTS: PLOTTED: 4/28/2020 2:02 PM
 PLOTTED BY: TFLR GRAFF



PLANT SCHEDULE

CODE	OVERSTORY TREES	SIZE
RM	RED MAPLE ACER RUBRUM	2" CAL
SH	SKYLINE HONEYLOCUST GLEDITSIA TRICANTHAS INERMIS 'SKYCOLE'	2" CAL
RO	RED OAK QUERCUS RUBRA	2" CAL
AL	AMERICAN LINDEN TILIA AMERICANA	2" CAL

CODE	EVERGREEN TREES	SIZE
SP	EASTERN WHITE PINE PINUS STROBUS	6'-7" HT
DF	DOUGLAS FIR PSEUDOTSGA MENZIESII	6'-7" HT
BS	BLACK HILLS SPRUCE PICEA GLAUCA 'DENSATA'	6'-7" HT

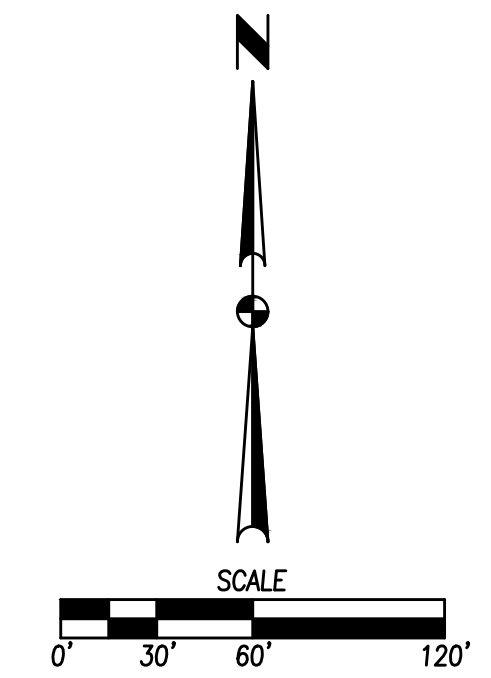

SHADOW CREEK PLAT 3
LANDSCAPE PLAN

31 / 31
 1704.221

3405 S.E. CROSSROADS DRIVE, SUITE G
 GRIMES, IOWA 50111
 PHONE: (515) 369-4400 FAX: (515) 369-4410

TECH: ENGINEER: RAH

CIVIL DESIGN ADVANTAGE
 CLIVE, IOWA

DATE: 10/23/18
 AS-BUILT SUBMITTAL: 09/18/18
 MAILBOX CLUSTER REVISION #2: 04/05/18
 MAILBOX CLUSTER REVISION: 03/14/18
 DETENTION BASIN OUTLET REVISION: 02/14/18
 FINAL SUBMITTAL: 10/26/17